

DRAWING NUMBER

PLAN HOLD CORPORATION • IRVINE, CALIFORNIA

REORDER BY NUMBER 075AR

POSITION LINE UP FIRST UP THIS LINE

DRAWING NUMBER

PLAN HOLD CORPORATION • IRVINE, CALIFORNIA

REORDER BY NUMBER 075AR

POSITION LINE UP FIRST UP THIS LINE

DRAWING NUMBER

PLAN HOLD CORPORATION • IRVINE, CALIFORNIA

REORDER BY NUMBER 075AR

POSITION LINE UP FIRST UP THIS LINE

A-104
Cantor
AA-07

DRAWING NUMBER

F. + 2. 104
TYP A
WTC

PLAN HOLD CORPORATION • IRVINE, CALIFORNIA

REORDER BY NUMBER 075AR

POSITION LINE UP FIRST UP THIS LINE

METROPOLITAN FIBER SYSTEMS OF NEW YORK AT THE WORLD TRADE CENTER

TENANT

THE CANTOR FITZGERALD SECURITIES COMPANY

LOCATION

ONE WORLD TRADE CENTER - 104th FLOOR

SHEET NUMBERS

AA

T1

T2

DRAWING NUMBERS

07-012--TYP-A-00A

07-012-1WT-P2-54-T1


07-012-1WT-P2-54-T2

DESCRIPTION

MFS-NT MASTER NOTES

80th FLOOR - PROPOSED CABLE ROUTES

104th FLOOR - PROPOSED CABLE ROUTES

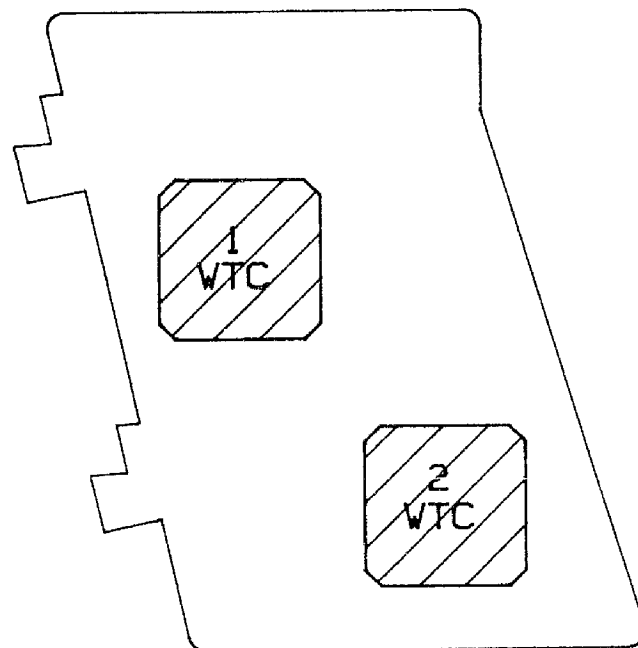

KEY PLAN
NTS



AS-BUILT

Tas*929)26

		KIEVIT NETWORK TECHNOLOGIES, INC.	
PROJECT METROPOLITAN FIBER SYSTEMS OF NEW YORK		INFORMATION ON THIS DOCUMENT IS PROPRIETARY AND SHALL NOT BE USED, COPIED, REPRODUCED OR DISCLOSED IN WHOLE OR IN PART WITHOUT WRITTEN CONSENT OF KNT	
TITLE WORLD TRADE CENTER PHASE 2		SCALE NOT TO SCALE	SIZE
ORIGIN	DATE	DRAWN	DATE
AL A	8/24/92	AL A	8/24/92
APPROVED	DATE		
AL A	8/24/92		